


NEW ADDITION. FOR MORE INFORMATION REFER TO DRAWING P1-2

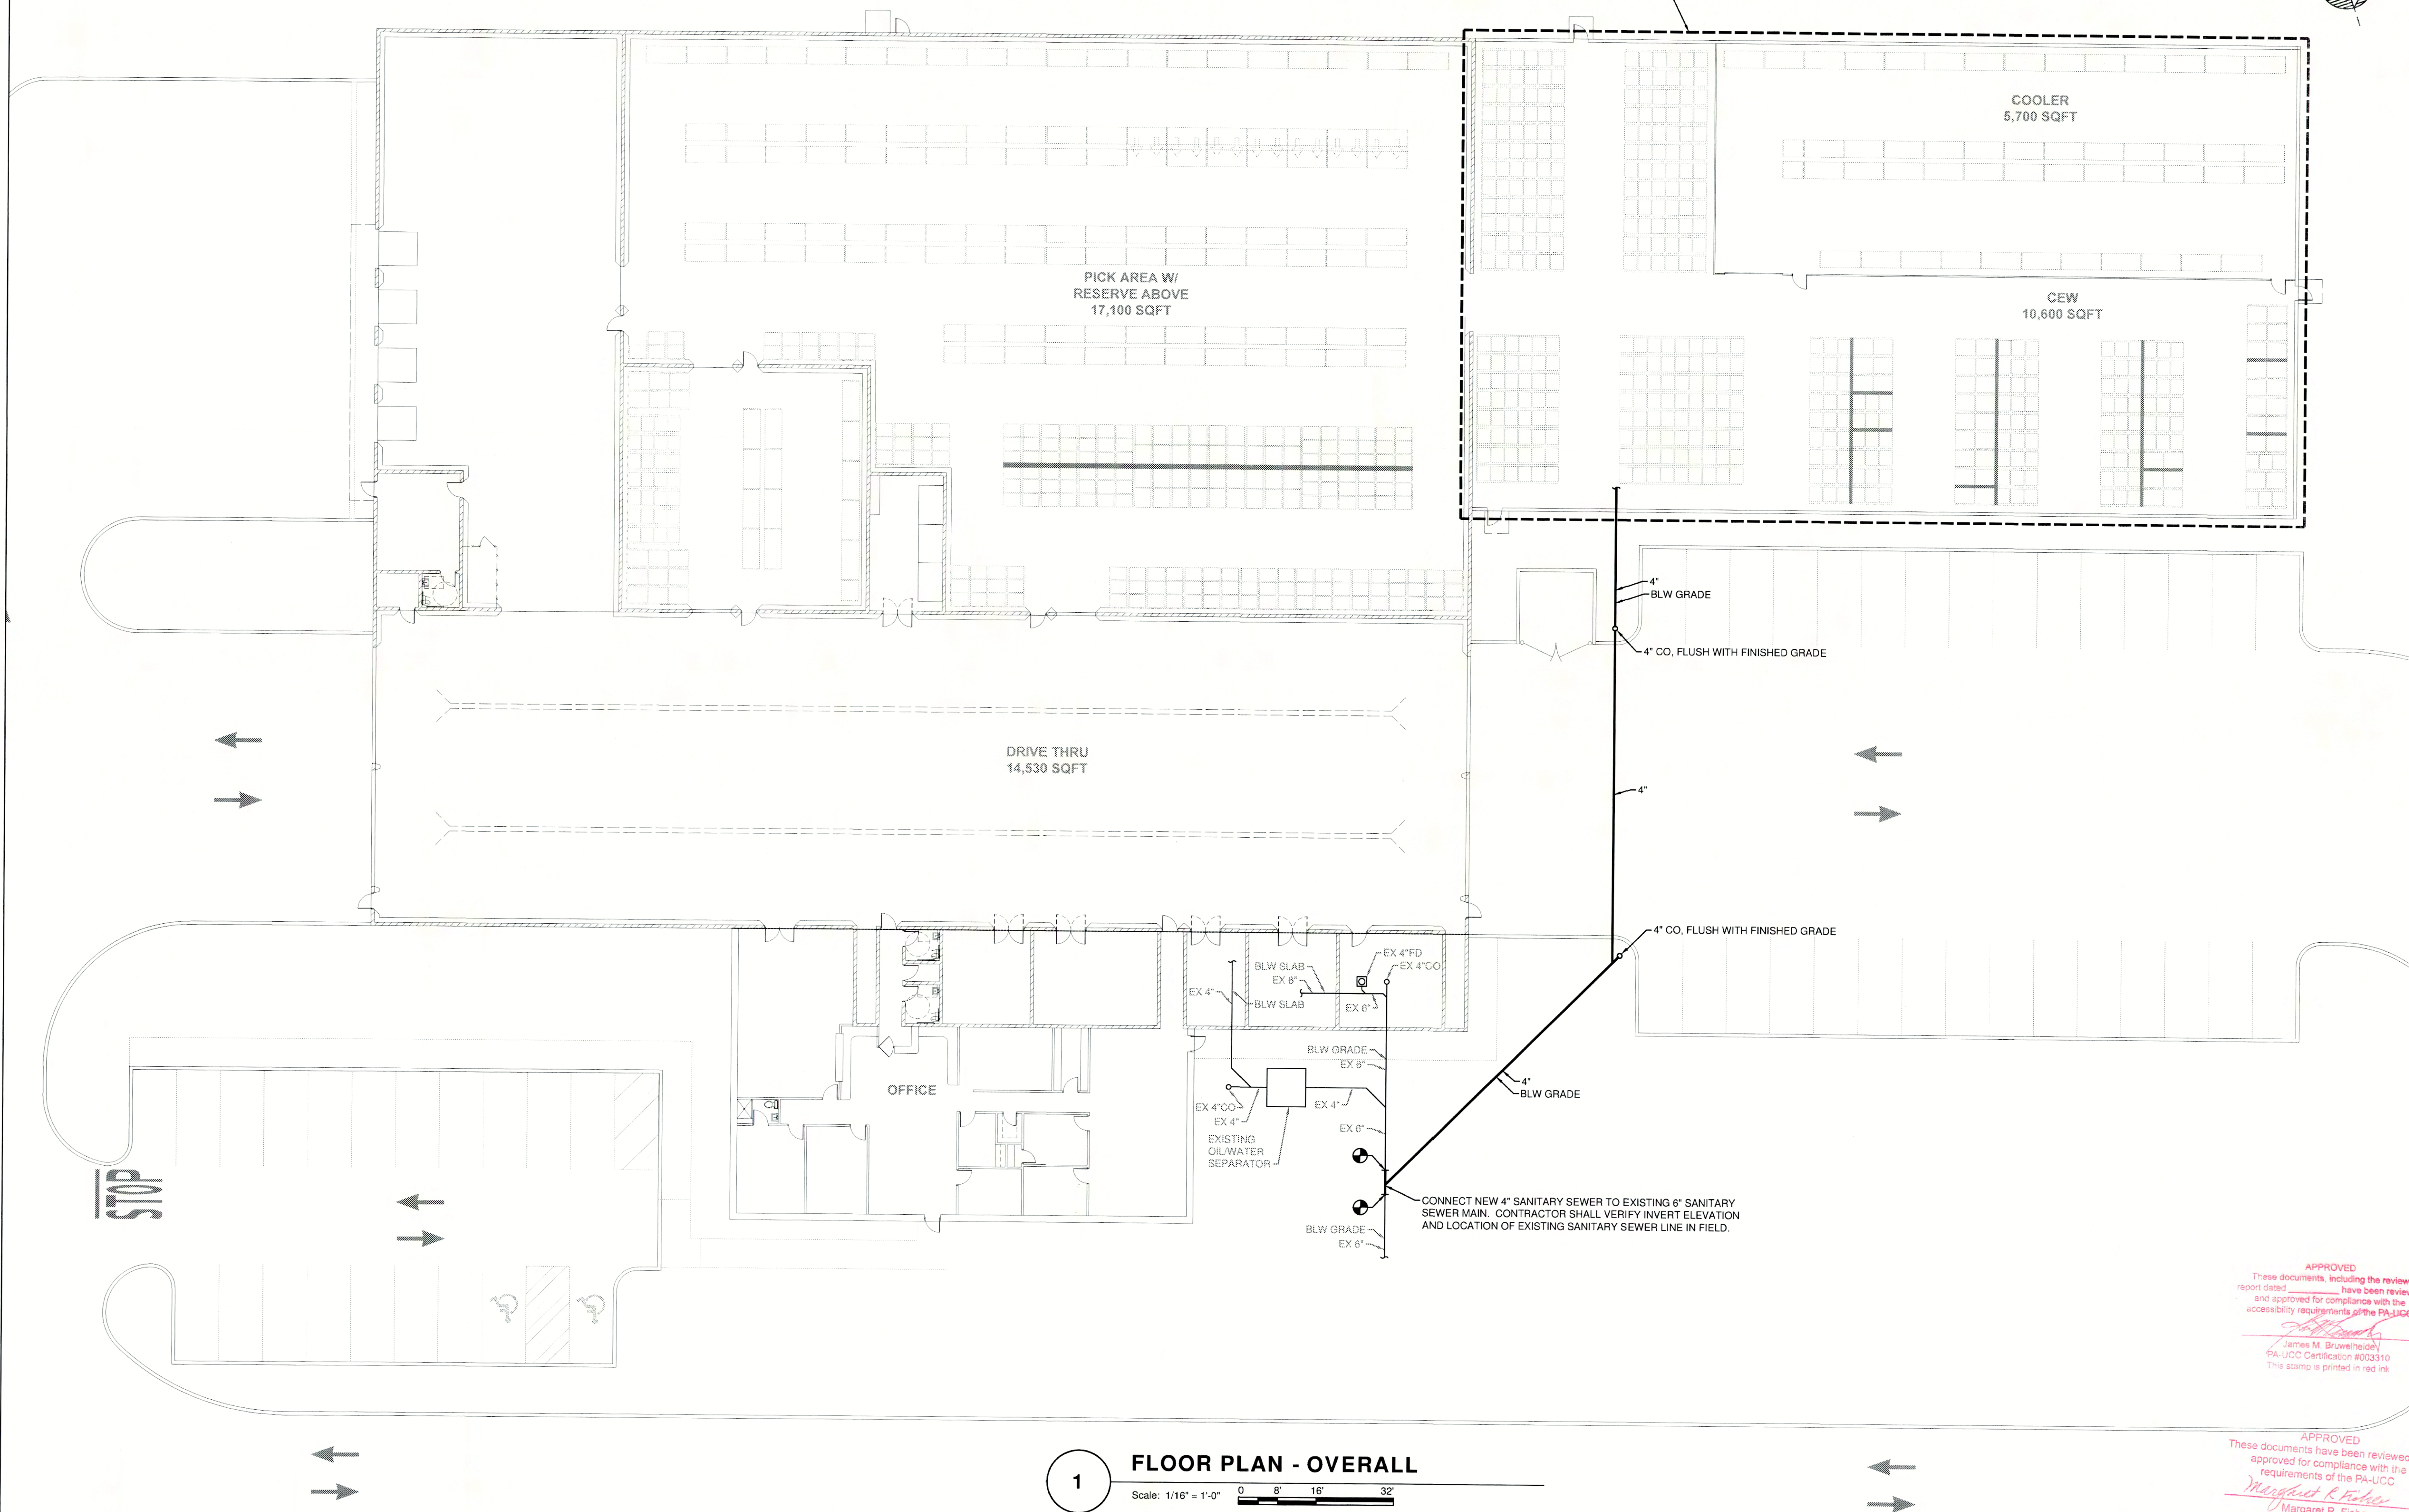

1 FLOOR PLAN - OVERALL
Scale: 1/16" = 1'-0"
0 8 16 32

APPROVED
These documents, including the review report dated 9/15/15, have been reviewed and approved for compliance with the accessibility requirements of the PA-UCC.
James M. Bruwelheide
James M. Bruwelheide
PA-UCC Certification #003310
This stamp is printed in red ink.

APPROVED
These documents have been reviewed and approved for compliance with the requirements of the PA-UCC.
Margaret R. Fisher
Margaret R. Fisher
PA-UCC Certification #003351
This stamp is printed in red ink.

NO.	REVISION	DATE
1	REVISION 1	9/15/15

JOB NO.	DRAWN BY	CHECKED BY	APPROVED BY	DATE PRINTED	DATE ISSUED
2015-0337-01	CAA	JCST	RES	9/22/15	9/22/15

VON'S UNITED BEVERAGE
BUILDING ADDITION
RICHLAND TWP, CAMBRIA COUNTY, PA
PLUMBING - OVERALL FLOOR PLAN